


NK GUSAR U KOMINU
ULICA BANA J. JELAČIĆA 13, KOMIN - PLOČE

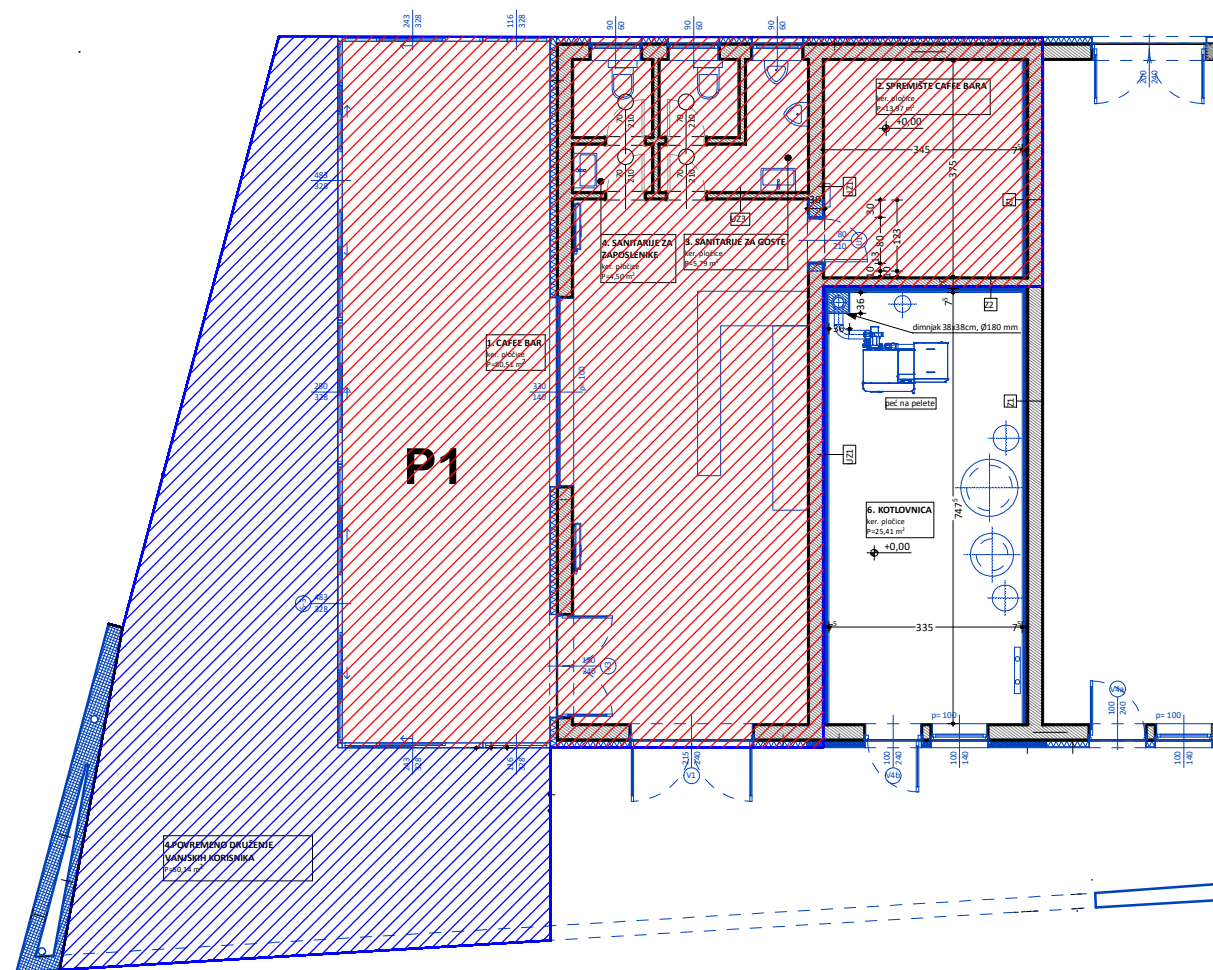

P1= 104,77 m²

50,14 m²

SADRŽAJ:	GRADEVINA: NK GUSAR U KOMINU
IZVEDENO STANJE	SADRŽAJ: TLOCRT