


DOM KULTURE U PERAČKOM BLATU
TRG JAKOVA OSTOJIĆA 1, PERAČKO BLATO - PLOČE

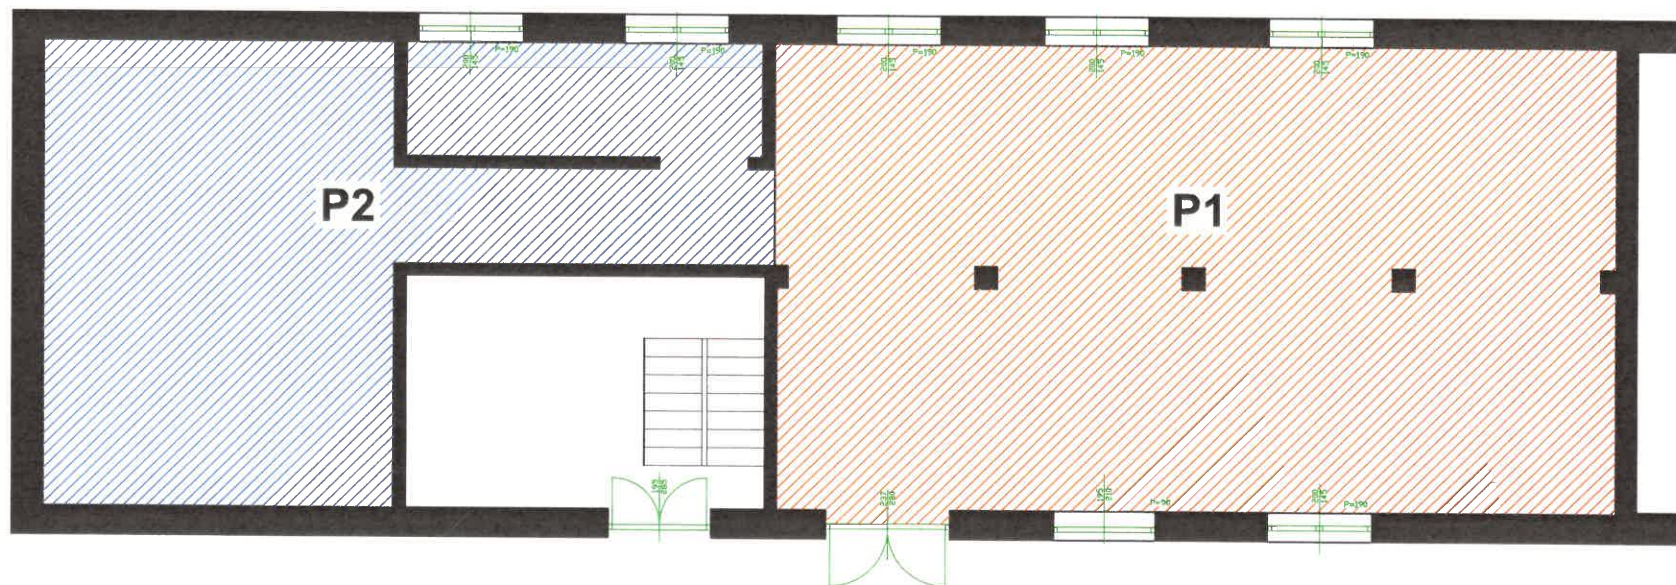

 **P1= 144,00 m²**

 **P2= 88,00 m²**

SADRŽAJ:	GRADEVINA:
IZVEDENO STANJE	DOM KULTURE PERAČKO BLATO
PLOČE	SADRŽAJ:
RUJAN 2026. god.	TLOCRT
	MJERILO:
	1 : 100